



EXISTING SECOND FLOOR PLAN

SCALE: $\frac{1}{8}''=1'-0''$

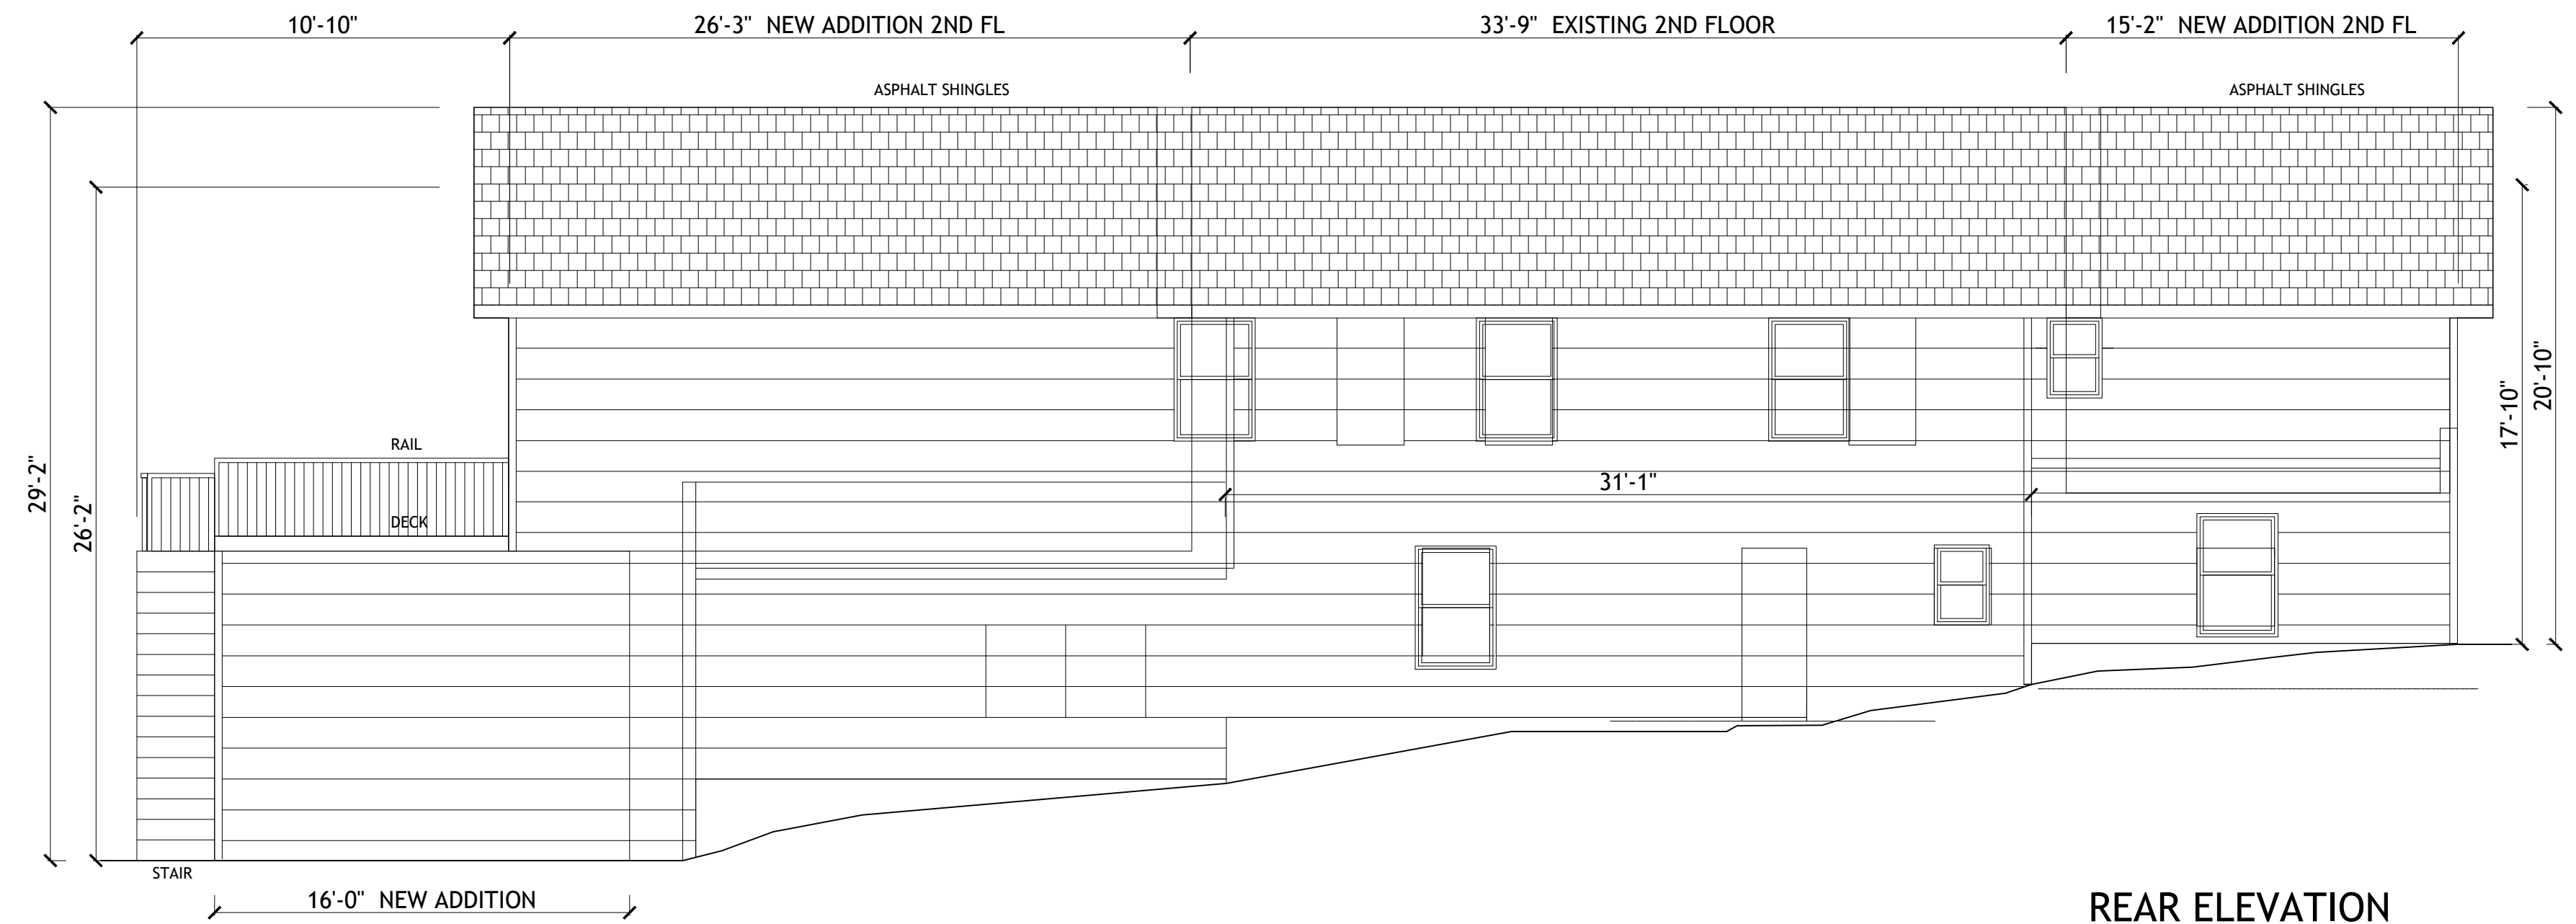

REAR ELEVATION

SCALE: $\frac{1}{8}''=1'-0''$

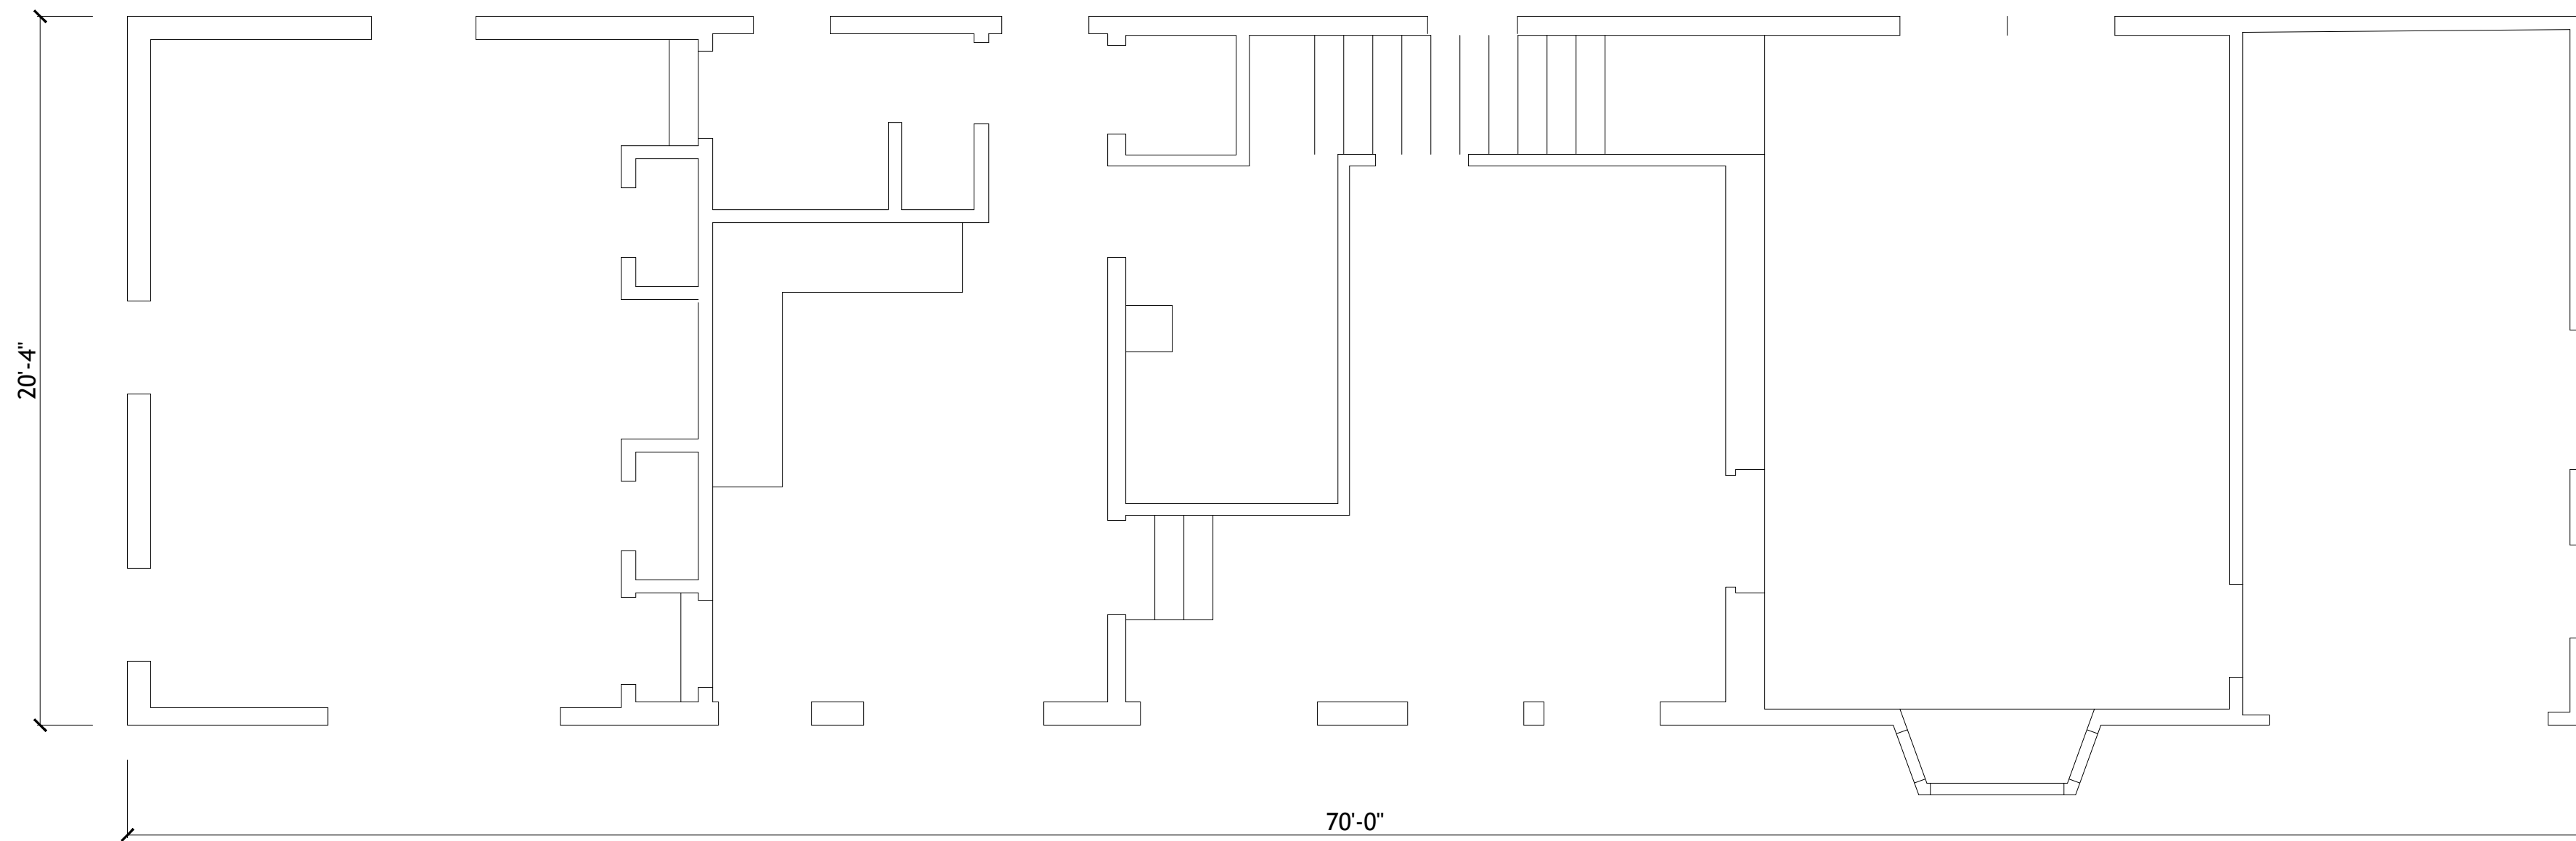


EXISTING FIRST FLOOR PLAN

SCALE: $\frac{1}{8}''=1'-0''$




LEFT SIDE ELEVATION

SCALE: $\frac{1}{8}''=1'-0''$

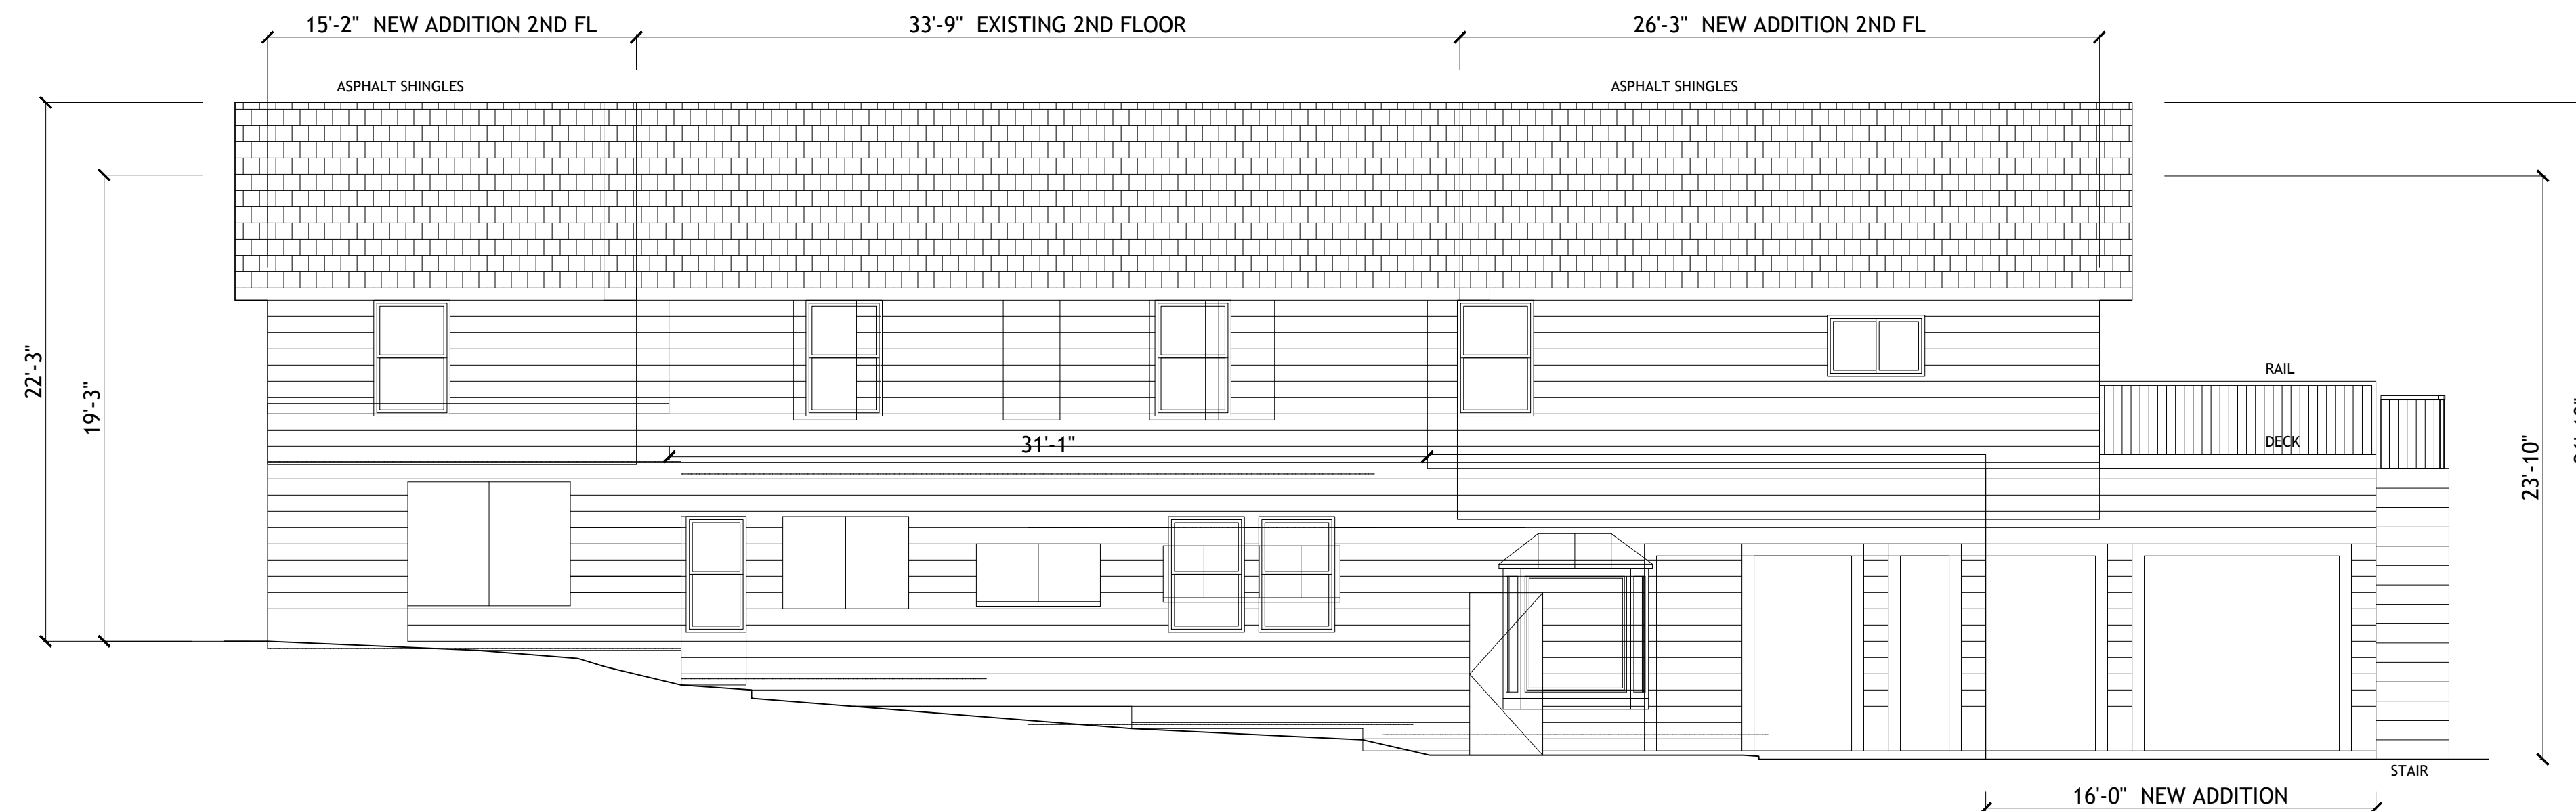

FRONT ELEVATION

SCALE: $\frac{1}{8}''=1'-0''$

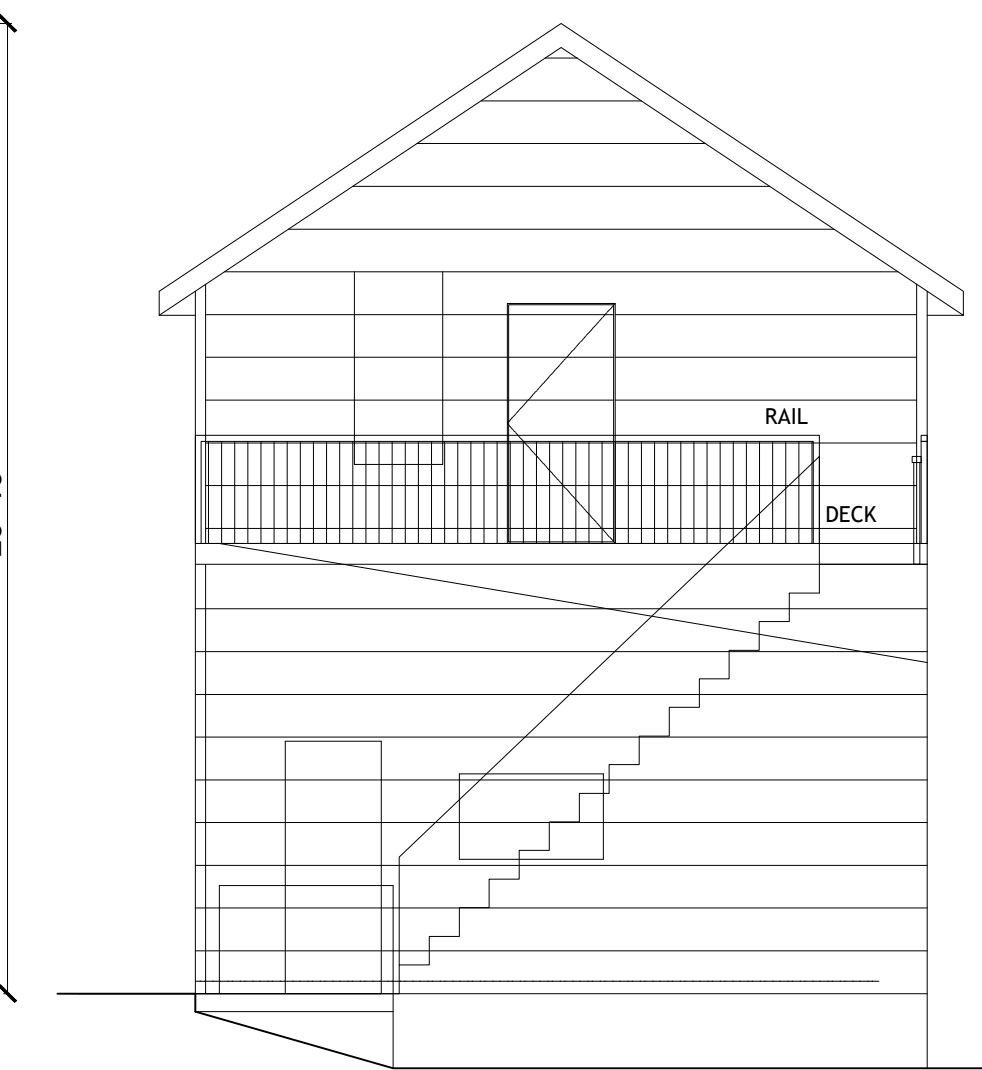

RIGHT SIDE ELEVATION

SCALE: $\frac{1}{8}''=1'-0''$

DATE:	
DATE:	

DATE:	28 APRIL 2022
DATE:	15 MAY 2023
DATE:	29 MAY 2023
DATE:	05 OCT 2023
DATE:	22 APR 2024

SCALE:	AS NOTED
SHEET:	A-1

WYMAN FISHER FUNERAL HOME
 100 FRANKLIN AVENUE
 PEARL RIVER, NEW YORK

AS-BUILT PLANS
 PROPOSED ELEVATIONS

BART M. RODI - ENGINEER
 RESIDENTIAL & COMMERCIAL
 234 SOUTH GRANT AVE
 CONGERS, NEW YORK 10920
 (845) 268-6663

NYS LIC #070545
 PLANS VALID ONLY IF SEALED

DO NOT SCALE PRINTS