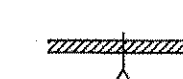
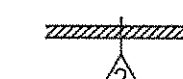
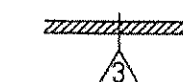



CONSTRUCTION LEGEND

PARTITION TYPES



PARTITION TYPE  TO EXTEND FROM FLOOR TO STRUCTURAL SLAB ABOVE AND SHALL HAVE 2 HOUR FIRE RATING. PROVIDE 3 5/8" METAL STUDS 16" O.C. WITH 2 LAYERS OF 5/8" THICK FIRE CODE GYPSUM BOARD ON EACH SIDE AND 4" THICK FIBERGLASS BLANKET INSULATION. PARTITION SHALL BE TAPED, SPACKLED AND SANDED SMOOTH TO RECEIVE PAINT. PROVIDE 2 BEADS OF SEALANT AT CEILING, FLOOR AND EXTERIOR WALLS.

PARTITION TYPE  TO EXTEND FROM FLOOR TO STRUCTURAL SLAB ABOVE. PROVIDE 3 5/8" METAL STUDS 16" O.C. WITH 1 LAYER OF 5/8" THICK FIRE CODE GYPSUM BOARD ON EACH SIDE AND 4" THICK FIBERGLASS BLANKET INSULATION EXCEPT WHERE CONC. BLOCK PARTITION WITH SMOOTH RAKED JOINTS. CLEAN PARTITION SURFACE AND PREPARE TO RECEIVE PAINT. SEE STRUCTURAL DRAWINGS FOR REINFORCING INFORMATION.

PARTITION TYPE  TO EXTEND FROM FLOOR TO STRUCTURAL SLAB ABOVE. PROVIDE 3 5/8" METAL STUDS 16" O.C. WITH 1 LAYER OF 5/8" THICK FIRE CODE GYPSUM BOARD ON EACH SIDE AND 4" THICK FIBERGLASS BLANKET INSULATION. PARTITION SHALL BE TAPED, SPACKLED AND SANDED SMOOTH TO RECEIVE PAINT. PROVIDE 2 BEADS OF SEALANT AT CEILING, FLOOR AND EXTERIOR WALLS.


PARTITION TYPE  TO EXTEND FROM FLOOR TO STRUCTURAL SLAB ABOVE. PROVIDE 6" CONC. BLOCK MASONRY PARTITION WITH SMOOTH RAKED JOINTS. CLEAN PARTITION SURFACE AND PREPARE TO RECEIVE PAINT. SEE STRUCTURAL DRAWINGS FOR REINFORCING INFORMATION.

NOTE:
FOR CONSTRUCTION NOTES AND SPECIFICATIONS SEE DWG. A-SPEC1 & A-SPEC2.

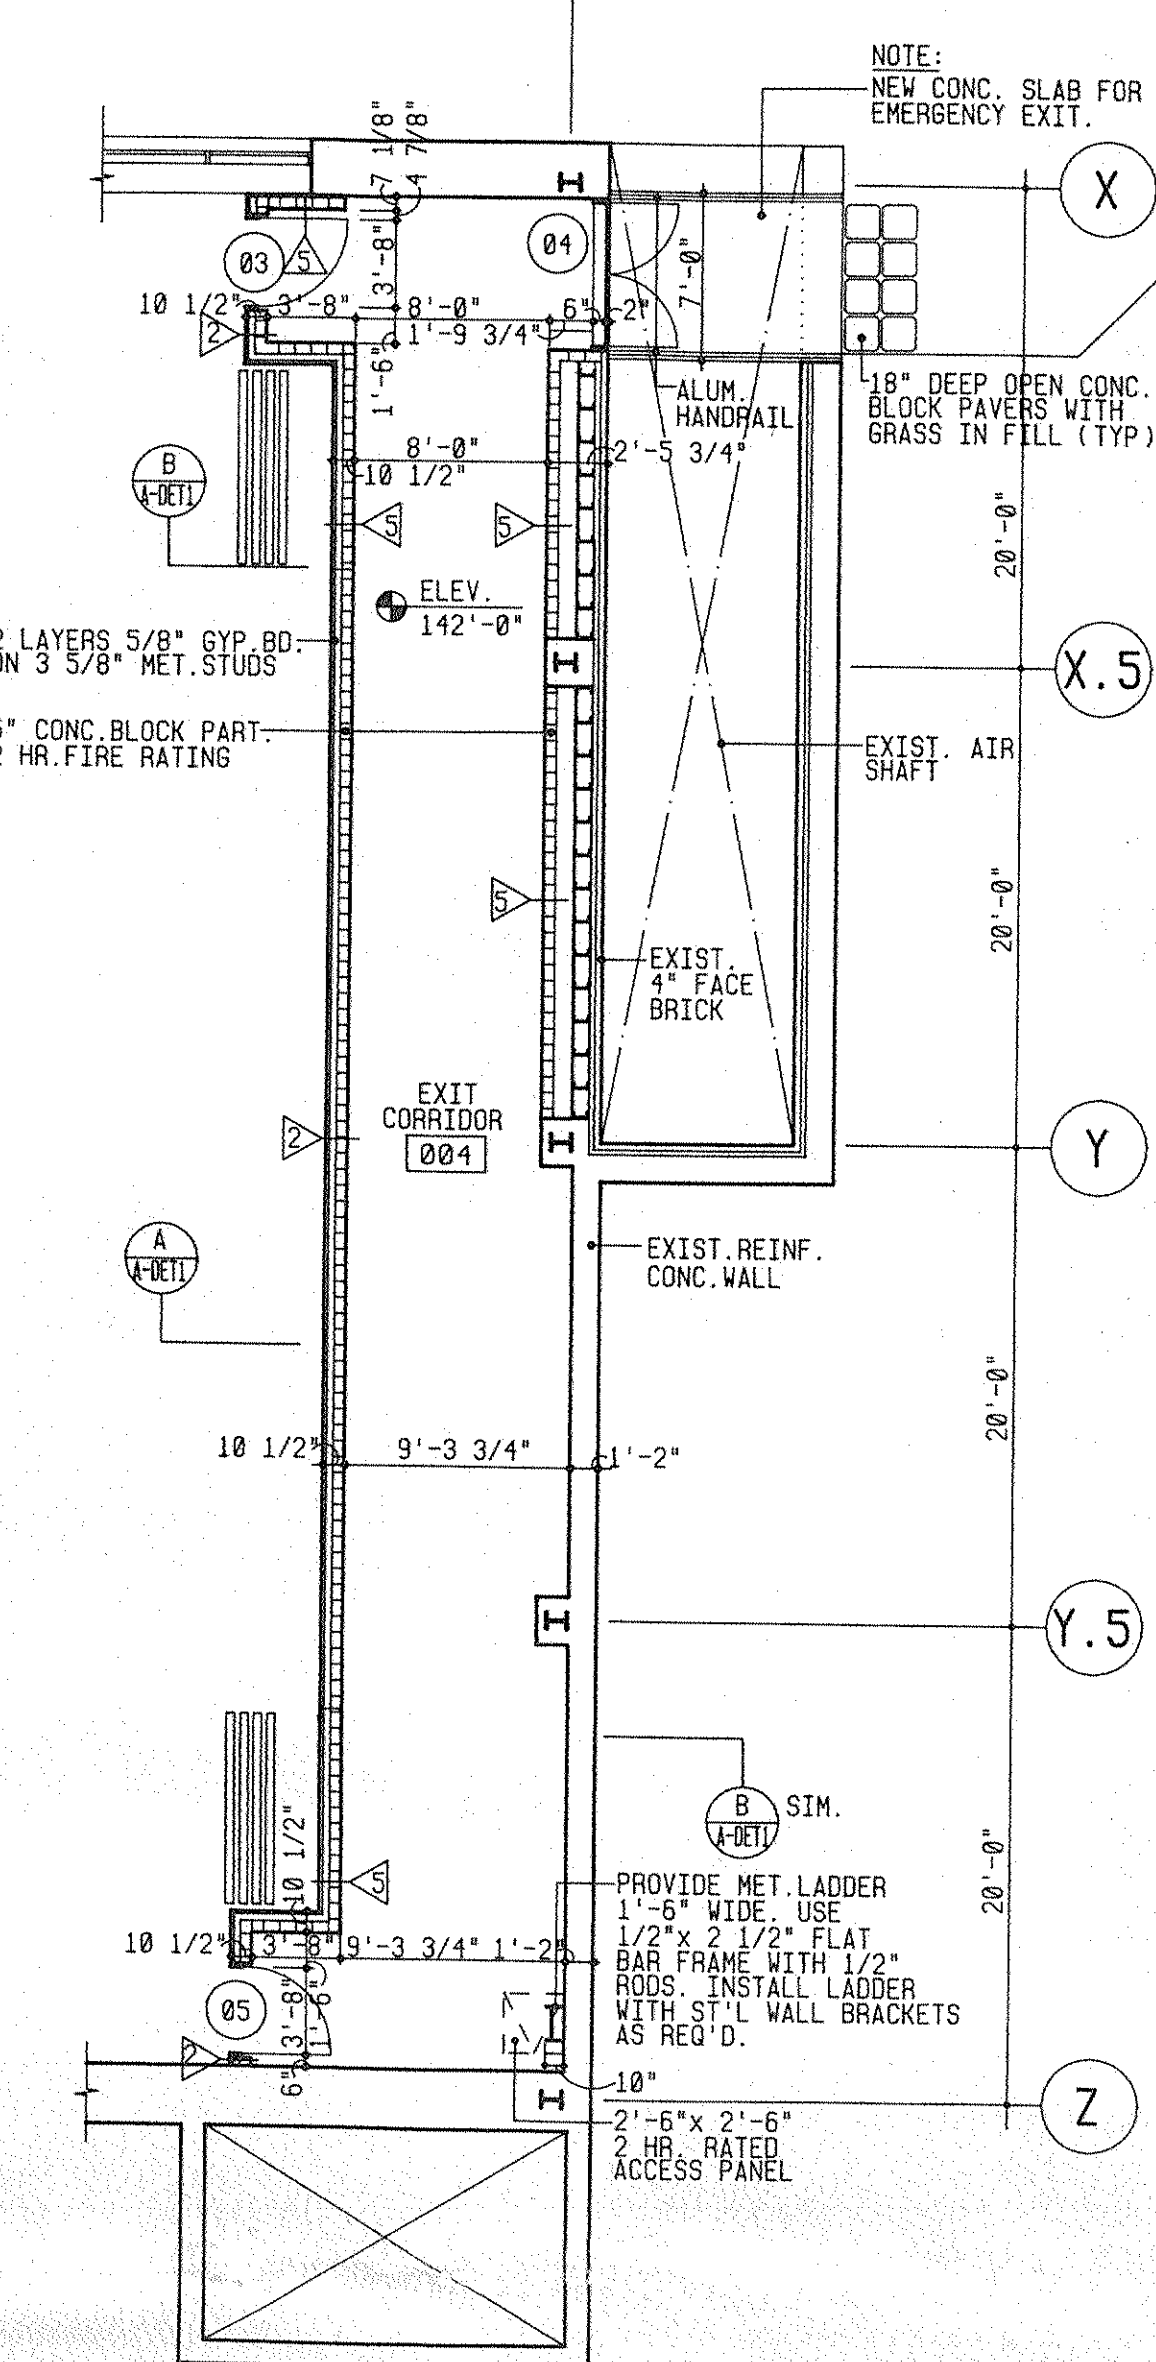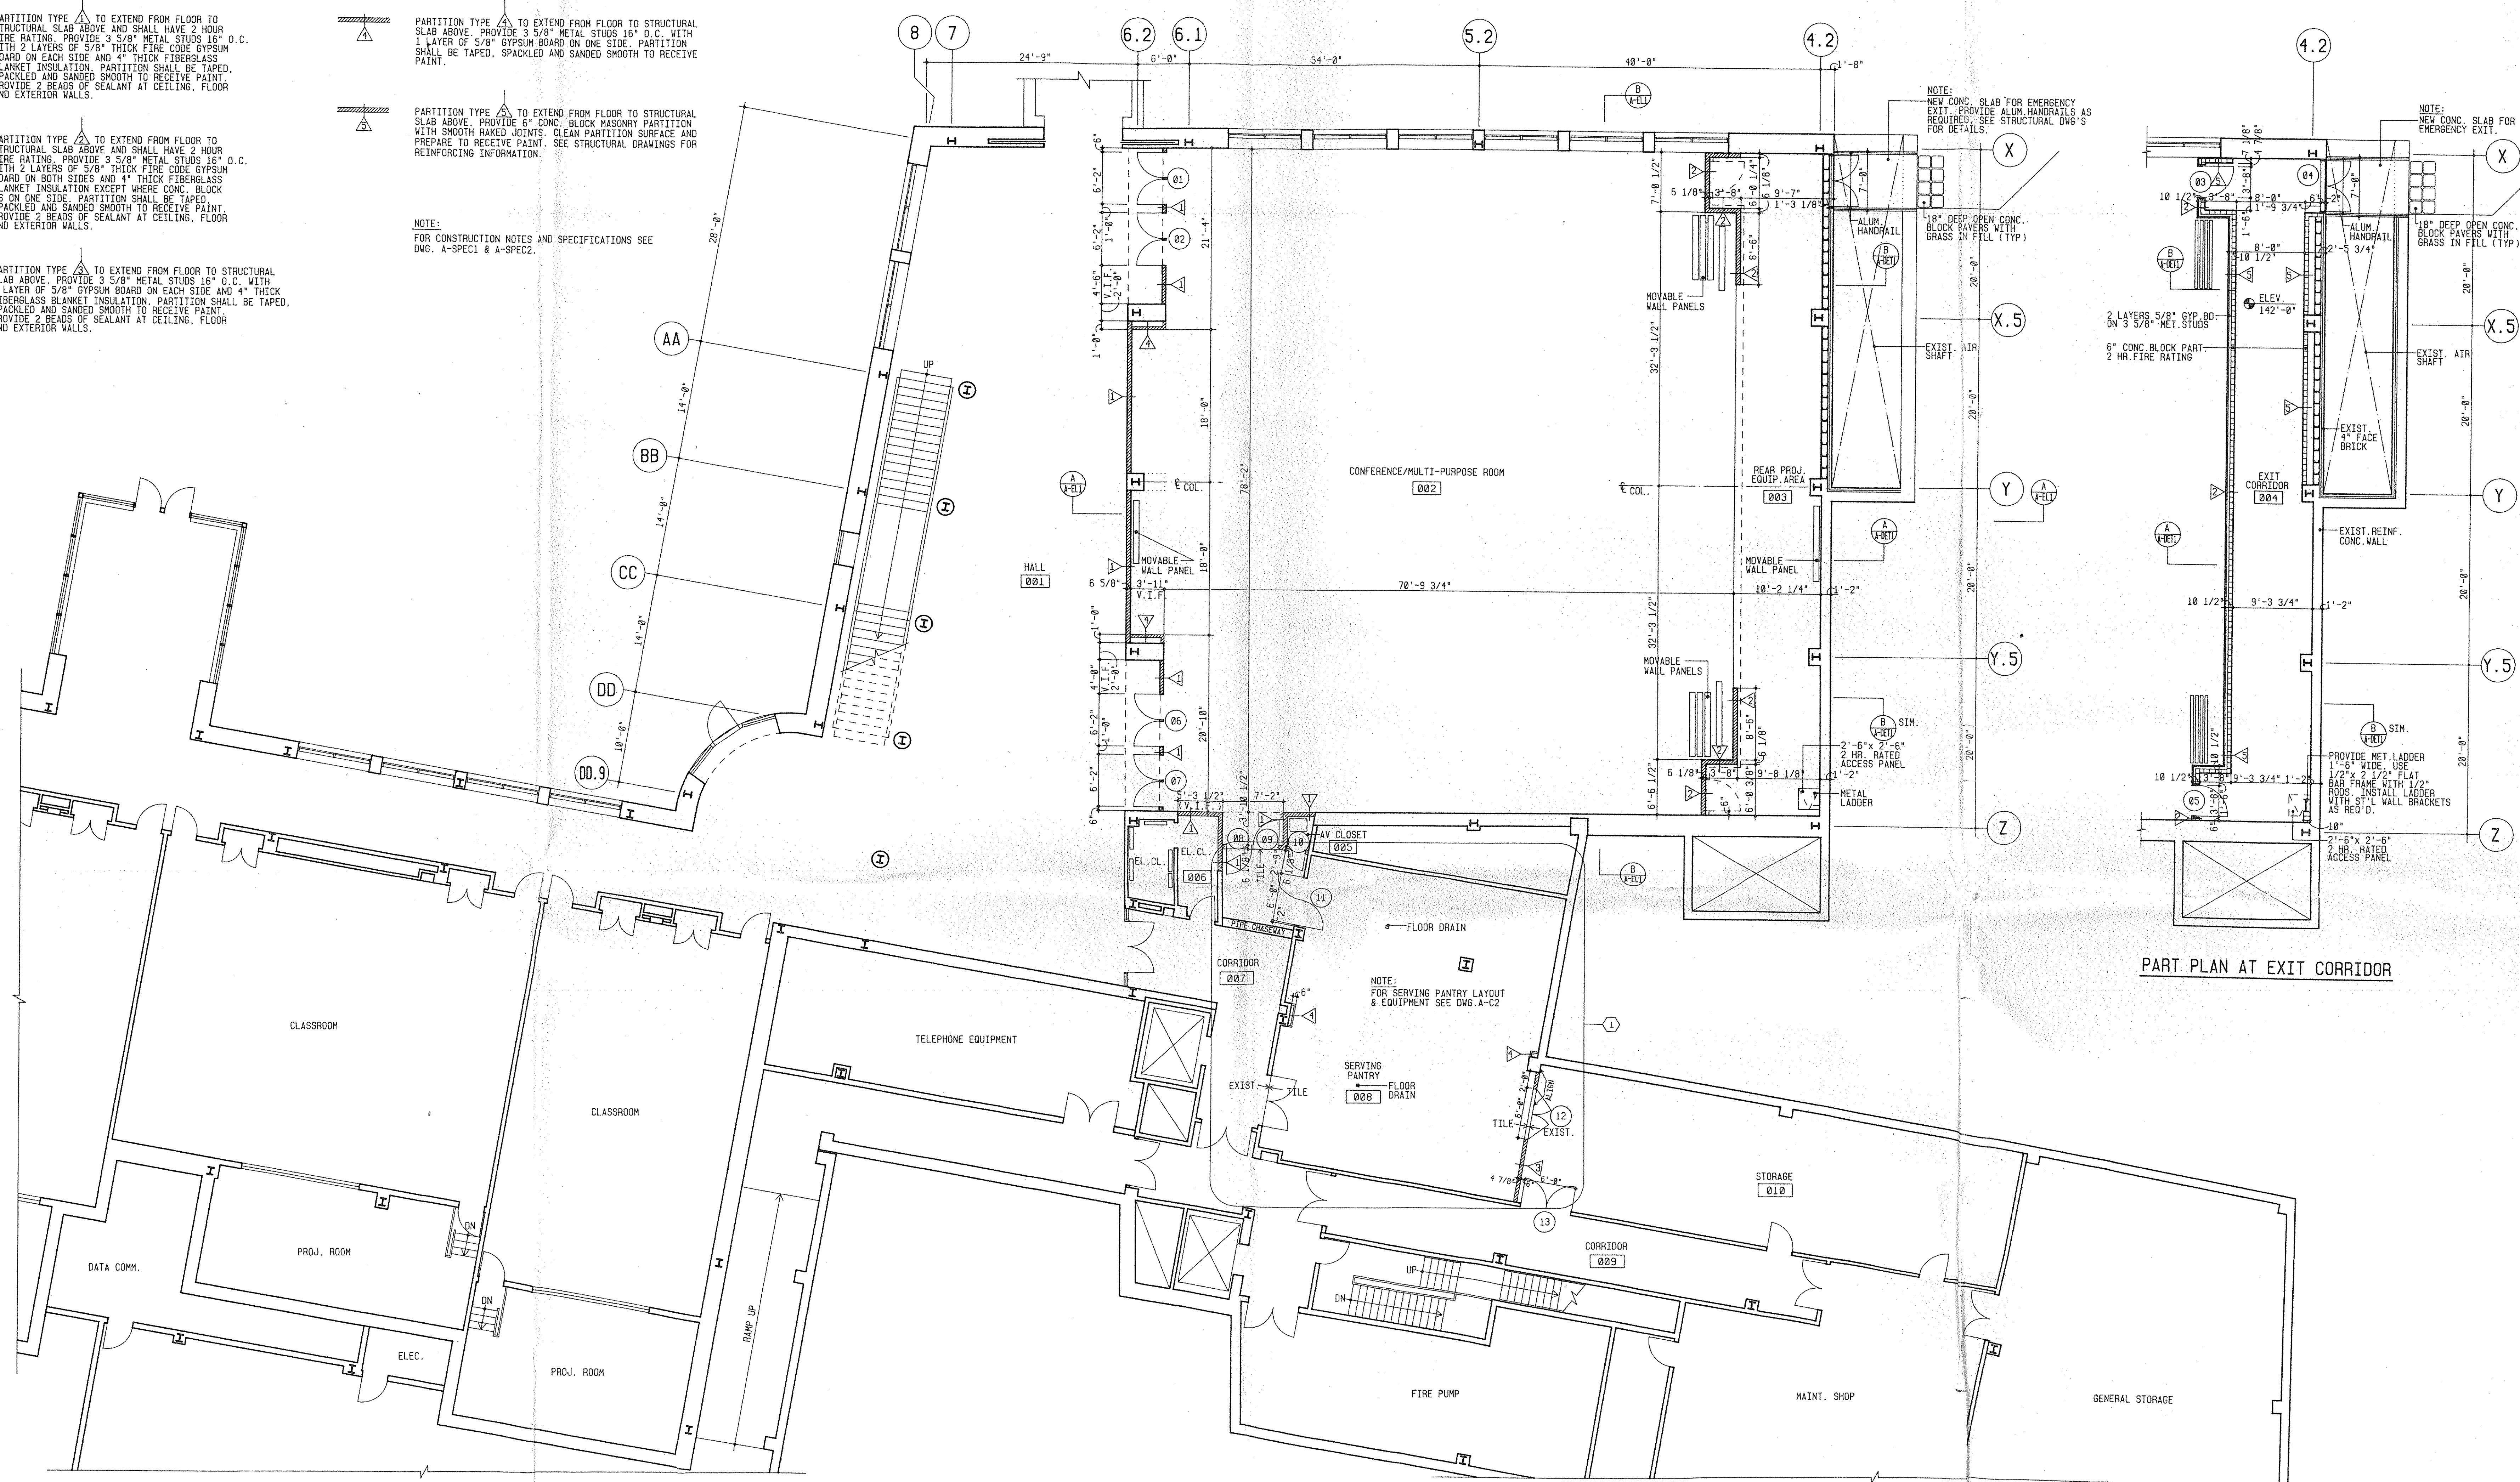

PART PLAN AT EXIT CORRIDOR

AS BUILT

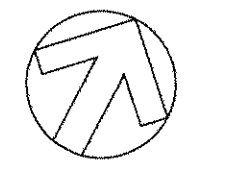












IBM ADVANCED BUSINESS INSTITUTE
PALISADES, NEW YORK

ARCHITECTS NAME AND ADDRESS:
ARMAND P. AVAKIAN ASSOCIATES, P.A. - ARCHITECTS AIA
31 ARCH STREET RAMSEY, NEW JERSEY 07446 TEL: 201-625-1616

PROJECT TITLE	CONFERENCE/MULTI-PURPOSE ROOM	LEVEL	142'-0"	DRAWN BY	EA
PROJECT LOCATION	M ADVANCED BUSINESS INSTITUTE PALISADES, NEW YORK			CHECKED BY	
DRAWING TITLE	CONSTRUCTION PLAN			SCALE	1/8"=1'-0"
DATE	SEPT. 12, 1994			DWG. NO.	A-C1

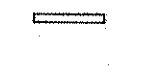
78.13-1-1

LEGEND


-  2' x 4' FLUORESCENT FIXTURE
-  PENDANT FIXTURE
-  RECESSED DOWN LIGHT
-  WALL MOUNTED SCONCES
-  1' x 4' WALL MOUNTED FLUORESCENT FIXTURE
-  EXIT LIGHT WITH DIRECTIONAL ARROWS
-  LINEAR DIFFUSER
-  CEILING SUPPLY DIFFUSER
-  CEILING RETURN DIFFUSER
-  CONCEALED SPRINKLER HEAD
-  SIDEWALL SPRINKLER HEAD



NOTES:


1. IN DEMOLITION AREAS WHERE PARTITIONS HAVE BEEN REMOVED REPAIR EXISTING SUSPENDED CEILING SYSTEM AND PROVIDE NEW TILES TO MATCH EXISTING AS REQUIRED. SEE FINISH SCHEDULE FOR LOCATIONS OF NEW AND EXISTING SUSPENDED CEILINGS.
2. FOR SUPPLY DIFFUSERS AND OTHER MECHANICAL FIXTURES SEE ELECTRO/MECH. DRAWINGS.
3. FOR LIGHTING FIXTURE TYPES SEE ELECTRICAL AND MECHANICAL DRAWINGS

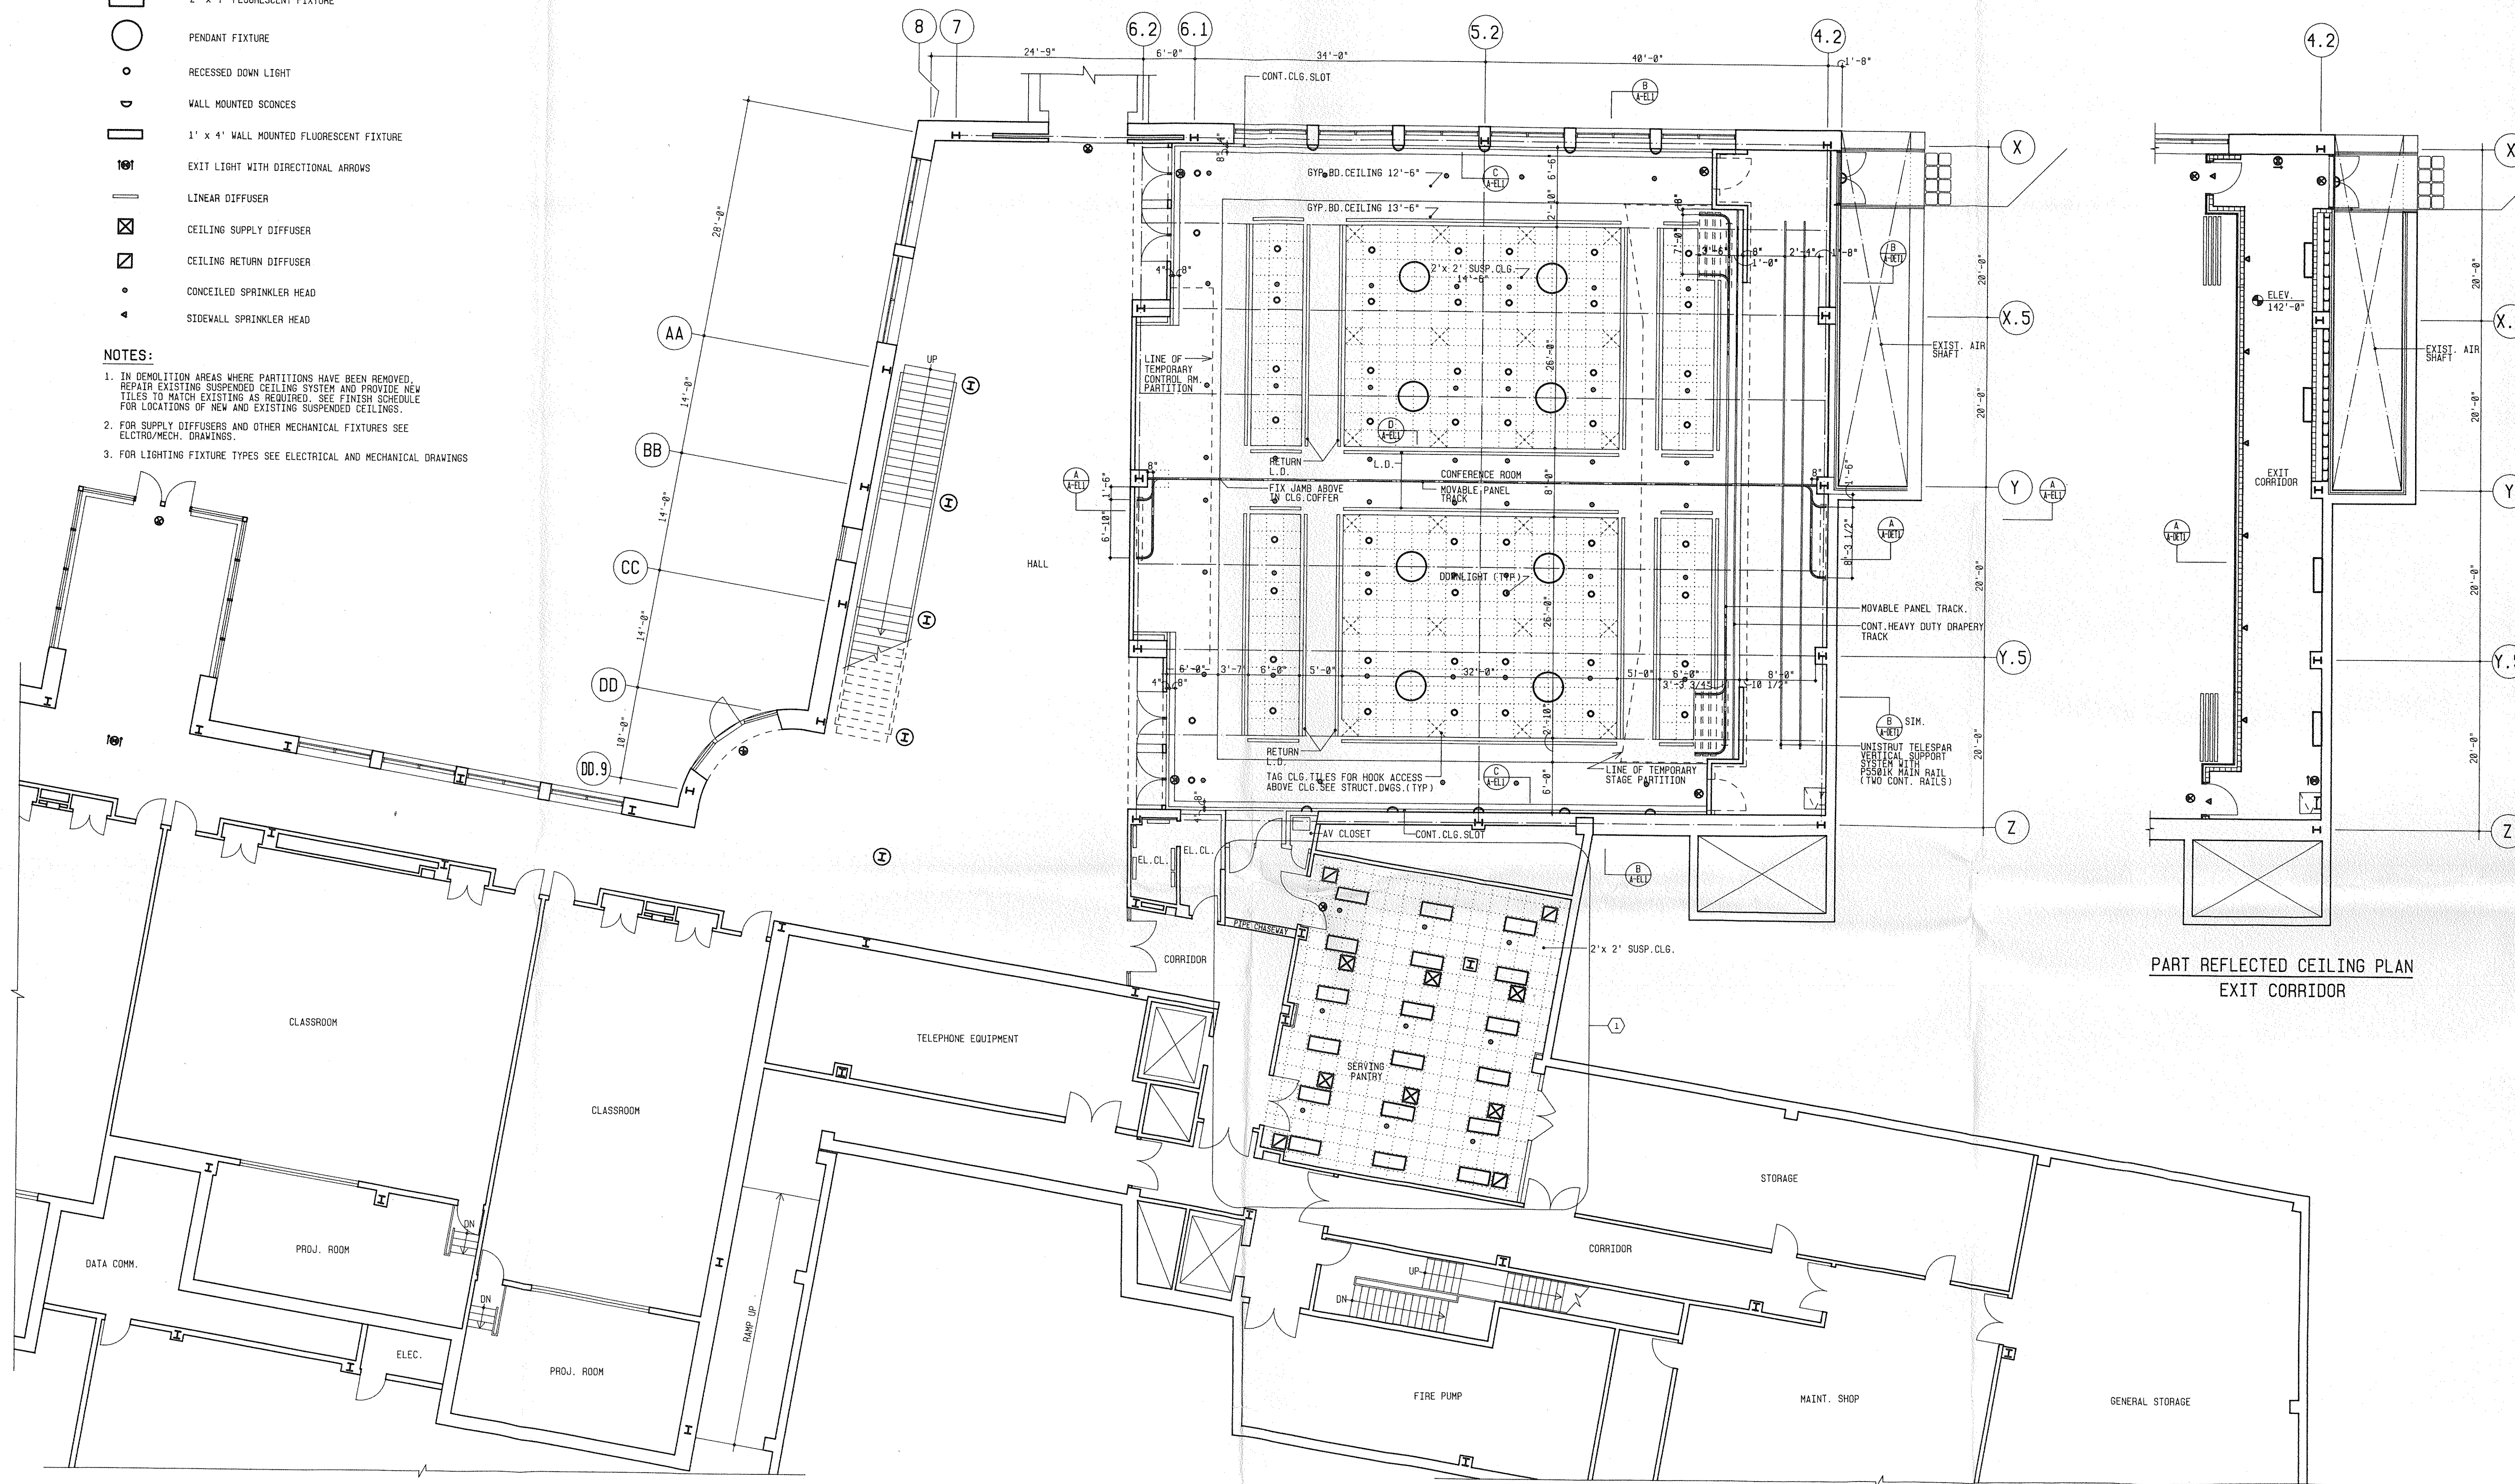

AS BUILT

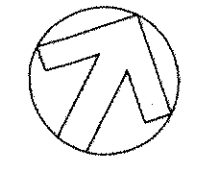

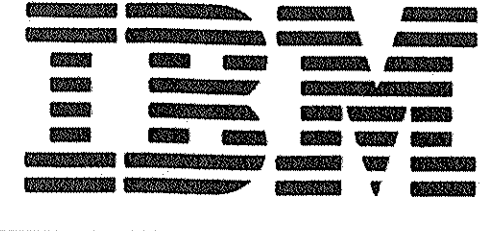
	ADVANCED BUSINESS INSTITUTE PALISADES, NEW YORK		PROJECT TITLE CONFERENCE/MULTI-PURPOSE ROOM	LEVEL 142'-0"	DRAWN BY EA	
	ARCHITECTS NAME AND ADDRESS: ARMAND P. AVAKIAN ASSOCIATES, P.A. - ARCHITECTS AIA 31 ARCH STREET RAMSEY, NEW JERSEY 07446 TEL: 201-628-1616		PROJECT LOCATION IBM ADVANCED BUSINESS INSTITUTE PALISADES, NEW YORK	DATE 12/12/94	CHECKED BY	SCALE 1/8"=1'-0"
			DRAWING TITLE REFLECTED CEILING PLAN			DWG. NO. A-RC1

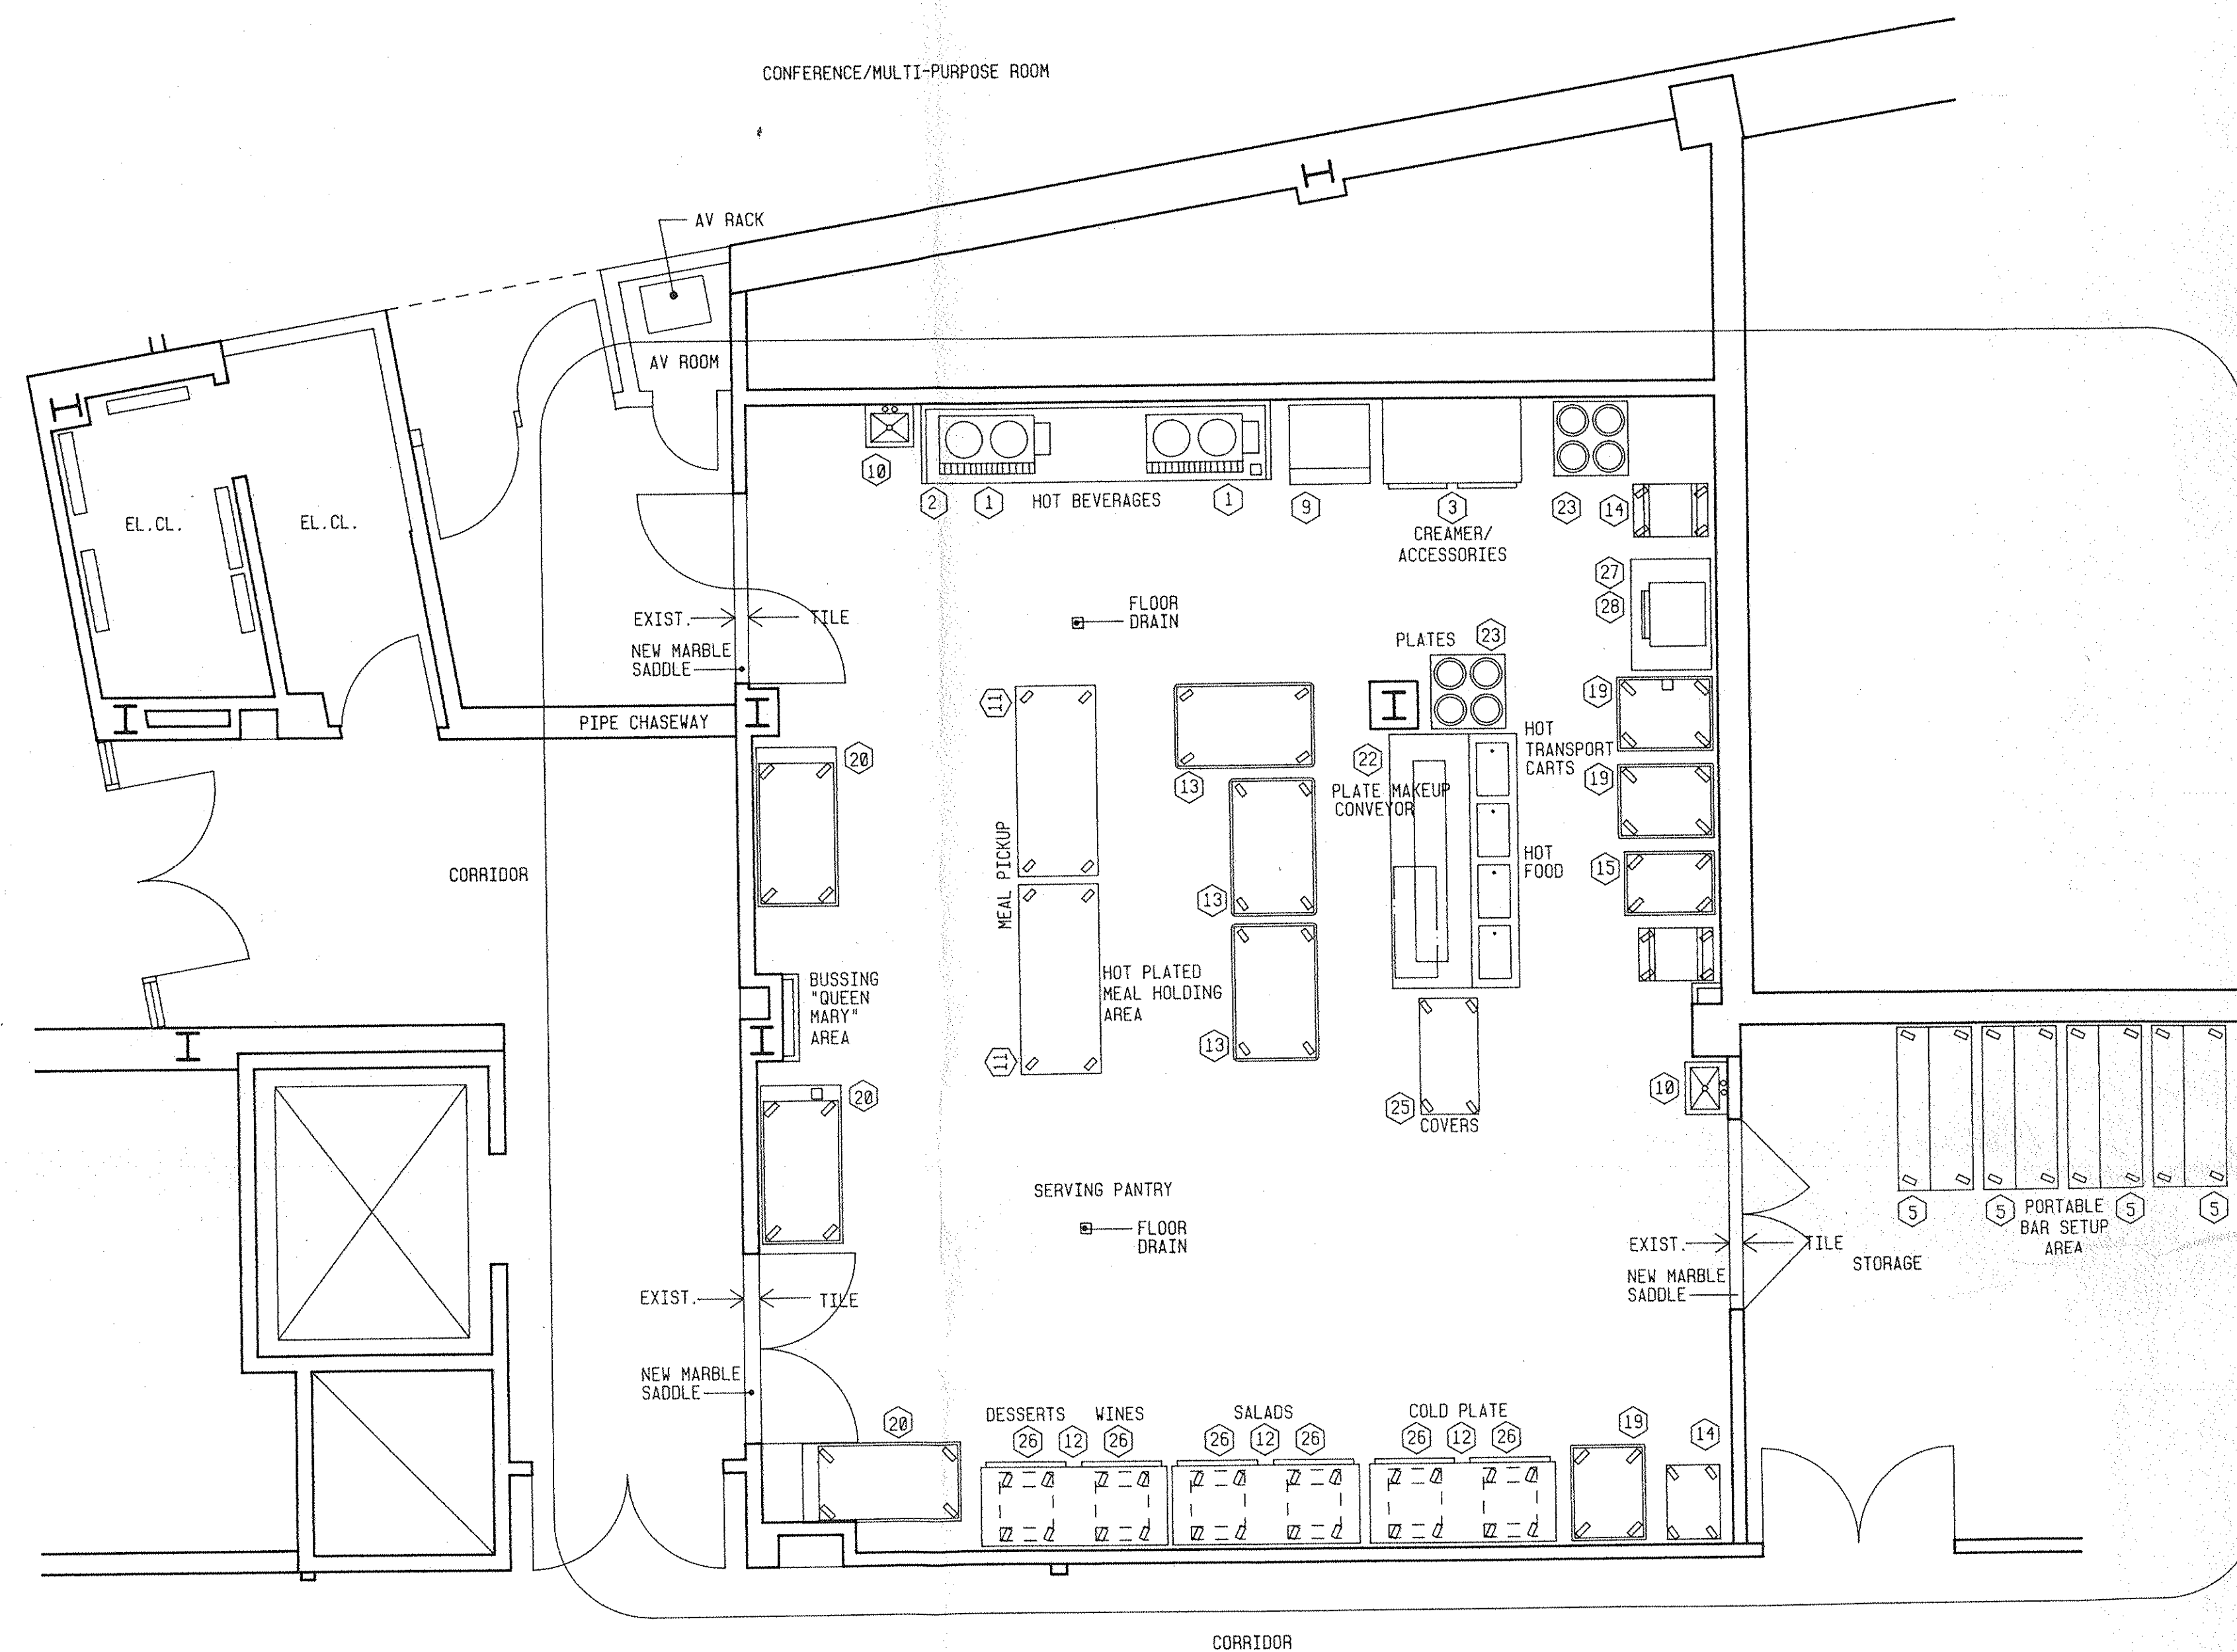

PANTRY PART PLAN
SCALE: 1/4"=1'-0"

ITEM	QUAN	DESCRIPTION	SOURCE	ELECTRIC											MECHANICAL											NOTES						
				V	PH	HP	A	KW	CONN	CW	HW	IV	W	S	CR	GAS	BTU															
1	2	COFFEE URN - 6 GALLON TWIN	BLICKMAN	120/208	3		36	12.	JB	3/8"																				EXISTING/RELOCATE VERIFY UTILITY REQUIREMENTS		
2	1	COFFEE COUNTER	FABRICATED							1/2"	1/2"	2 1/4"																	WITH COLDWATER FILL HOSE			
3	1	REFRIGERATOR - BEVERAGE	VICTORY	120	1	1/3	10		JB																							
4	-	SPARE NUMBER																														
5	4	MOBILE BAR UNITS - MOBILE	CARTER HOFFMAN	120	1	1/2			C&P			3/4"																				
6	-	SPARE NUMBER																														
7	-	SPARE NUMBER																														
8	-	SPARE NUMBER																														
9	1	ICEMAKER W/STORAGE BIN	SCOTSMAN	120	1	3/4	19.0		JB	3/8"	1/2"	1/2"																				
10	2	HANDSINK W/FAUCET	SECO							1/2"	1/2"	1 1/2"																				
11	2	WORKTABLES - MOBILE	FABRICATED																													
12	3	REFRIGERATOR - ROLL IN 2 SECT	VICTORY	120	1	1/2	11.6		JB																							
13	5	HEATED BANQUET CARTS	CARTER HOFFMAN	120	1		13	1.5	C&P																						THREE SHOWN	
14	2	MOBILE PANSIDE CART-UTILITY	SECO																													
15	2	TRANSPORT CABINETS-UTILITY	SECO																													
16	-	SPARE NUMBER																														
17	-	SPARE NUMBER																														
18	-	SPARE NUMBER																														
19	3	HEATED BULK TRANSPORT CART	SECO	120	1		14.6	1.7	C&P																							
20	5	BUSSING CARTS "QUEEN MARY"	CARTER HOFFMAN																													THREE SHOWN
21	1	HOT FOOD TABLE	FABRICATED	208	1		4.0		C&P	1/2"		3/4"																				
22	1	PLATE MAKEUP CONVEYOR	SECO	208	1	1.0			C&P																							
23	2	HEATED PLATE CARTS	SECO	120	1		22		C&P																							
24	-	SPARE NUMBER																														
25	1	UTILITY CART (PLATE COVER)	SECO																													
26	6	MOBILE REFRIGERATOR RACKS	SECO																													
27	1	MOBILE TABLE 30"x 42"	FABRICATED																													
28	1	MICROWAVE OVEN	PANASONIC	208	1		17		C&P																							


AS BUILT

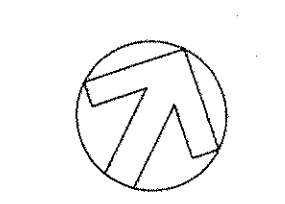

IBM ADVANCED BUSINESS INSTITUTE
PALISADES, NEW YORK

ARCHITECTS NAME AND ADDRESS:
ARMAND P. AVAKIAN ASSOCIATES, P.A. - ARCHITECTS AIA
31 ARCH STREET RAMSEY, NEW JERSEY 07446 TEL: 201-925-1616

© CONTENTS AND DESIGN MAY NOT BE REPRODUCED WITHOUT PERMISSION AND CREDIT

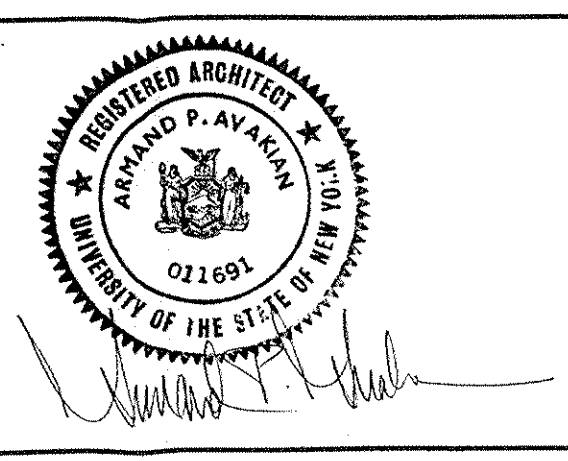

AS BUILT	1558	DATE	PROJECT TITLE	PROJECT NO.	DRAWN BY
PIPE CHASEWAY TO REMAIN HALL REMOVED 11/28 DOORS ADDED 1994 EQUIPMENT CHANGES.			CONFERENCE/MULTI-PURPOSE ROOM	LEVEL 142'-0"	EA
			PROJECT LOCATION		CHECKED BY
			IBM ADVANCED BUSINESS INSTITUTE PALISADES, NEW YORK		SCALE AS NOTED
			DRAWING TITLE		DATE SEPT. 12, 1994
			PANTRY PART PLAN & SCHEDULE		DWG. NO.
					A-C2